
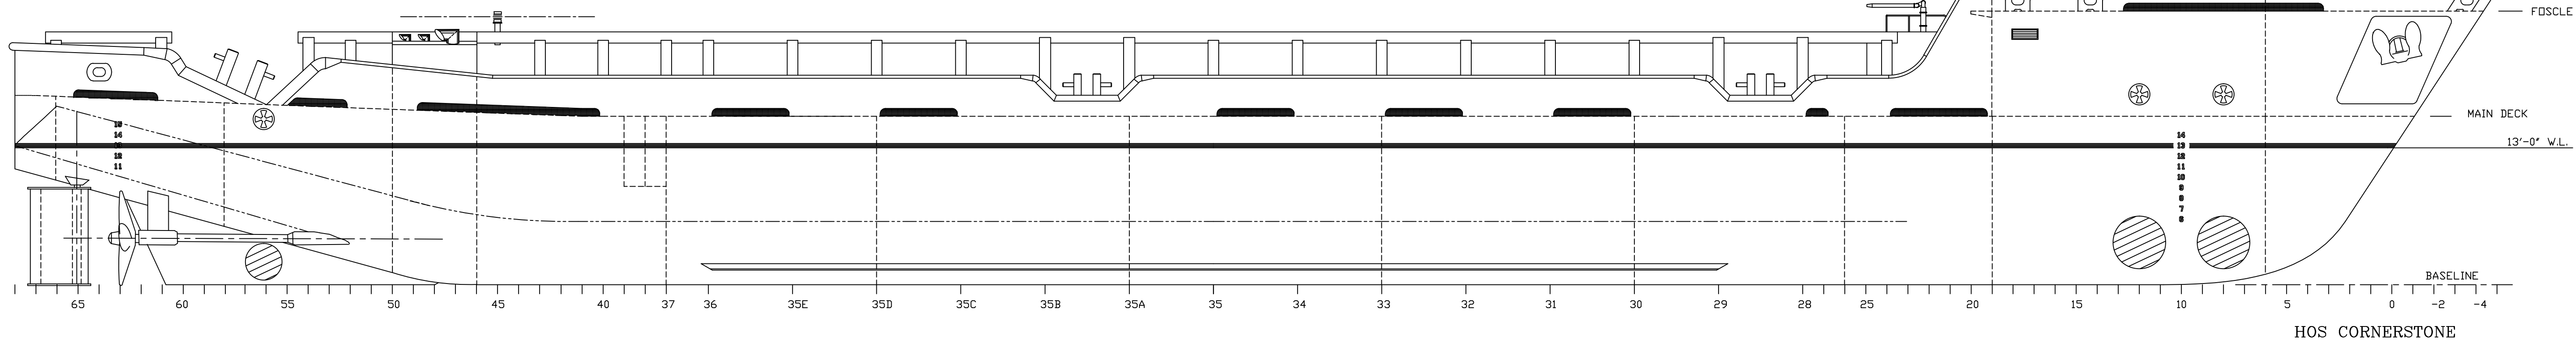
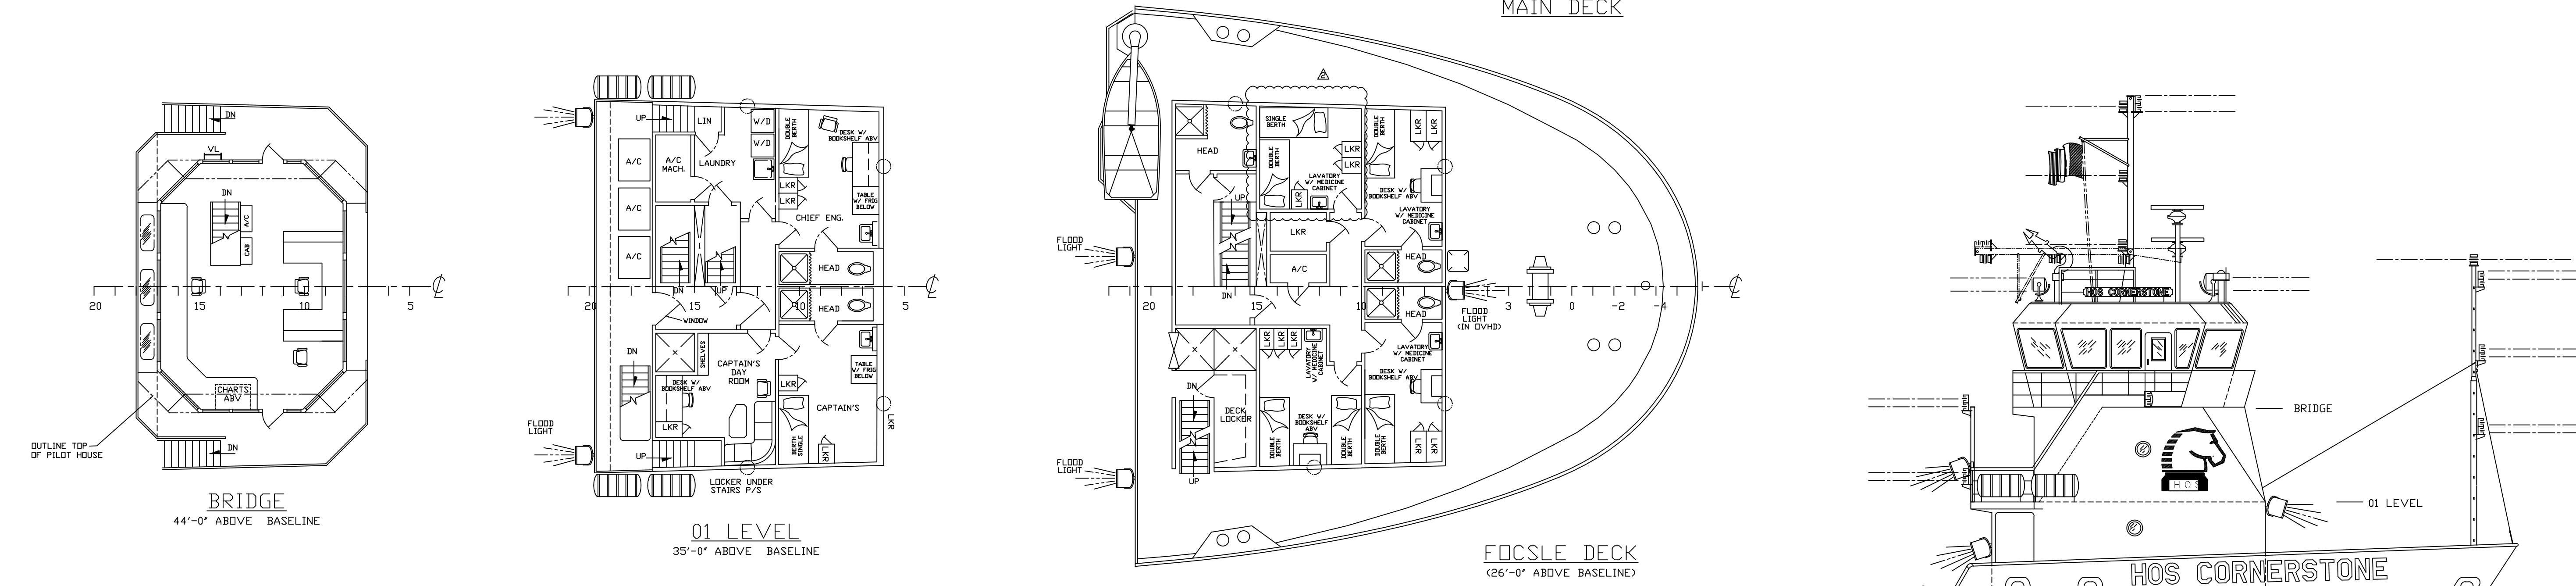


REVISIONS		
REV	DESCRIPTION	DATE
1	GENERAL AS-BUILT REVISION FOR LV	
2	ADDED BERTH TO PORT STATEROOM ON FOCLE DECK	6-12-12

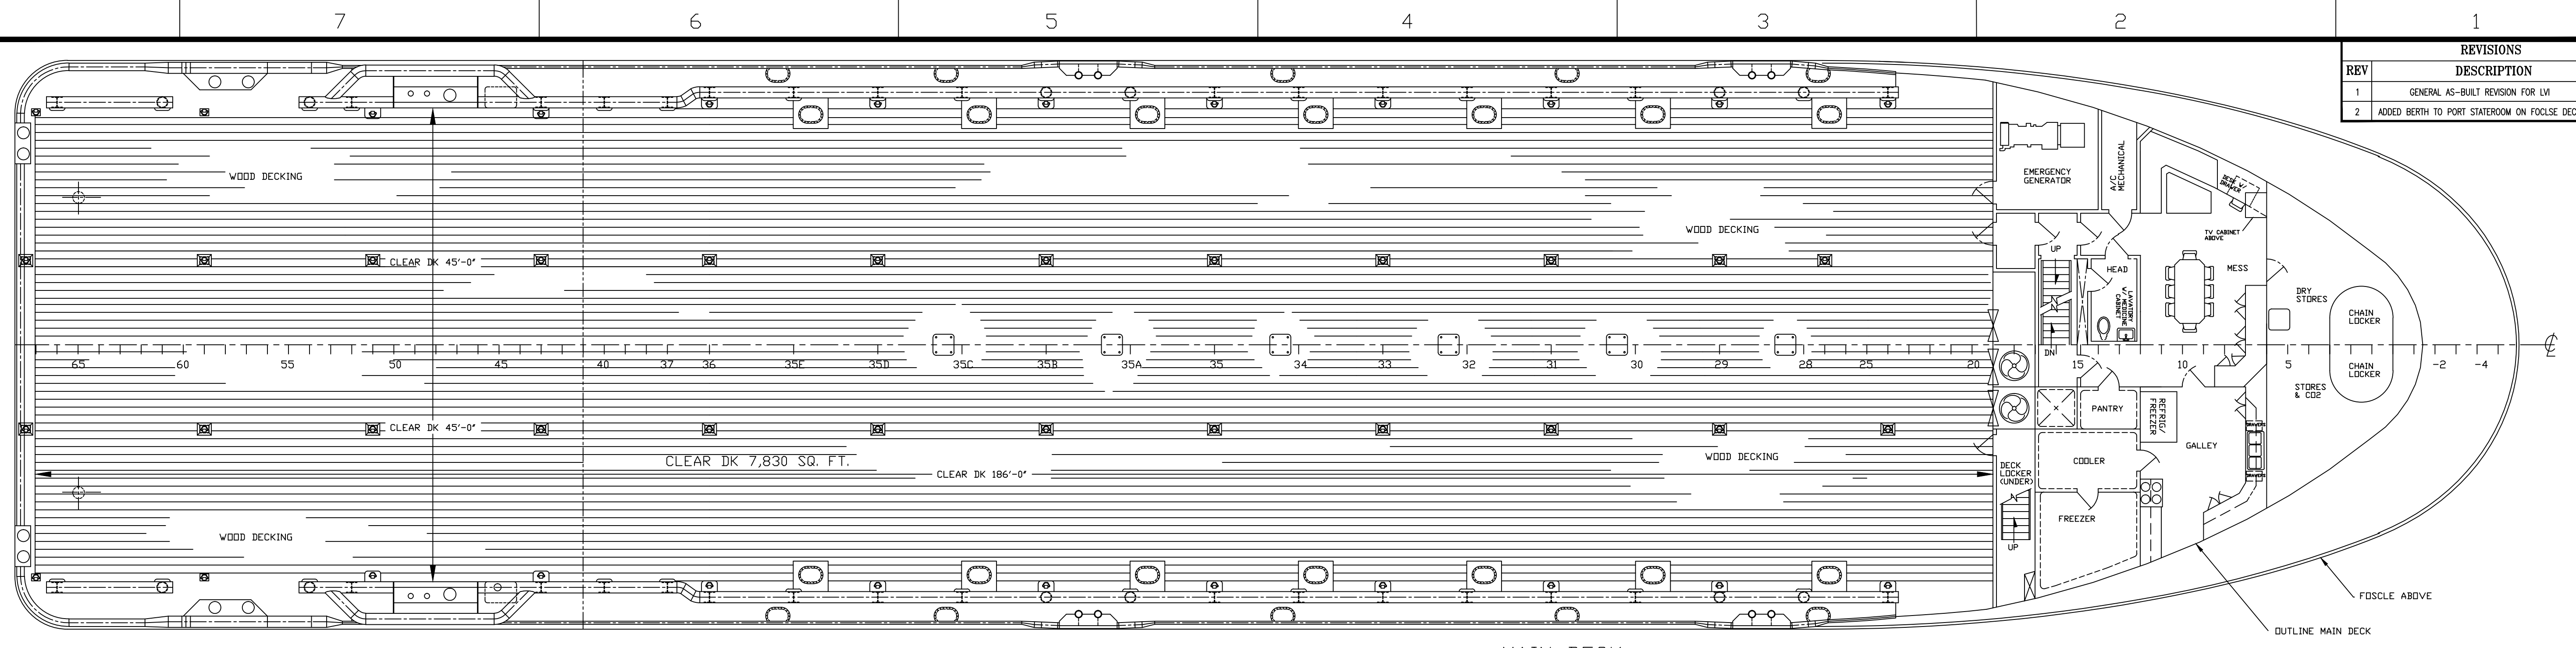

HOS CORNERSTONE

THIS DRAWING, DESIGN CONCEPT AND SPECIFICATIONS ARE THE PROPERTY OF HORNBECK OFFSHORE SERVICES AND ARE FURNISHED ON A CONFIDENTIAL BASIS WITH AN EXPRESSED UNDERSTANDING THAT THEY WILL NOT BE COPIED, IN ANY MANNER USED FOR MANUFACTURE, SOLD, TRANSFERRED, NOR USED TO THE BESTMENT OF SAID FIRM WITHOUT WRITTEN PERMISSION.

HORNBECK OFFSHORE SERVICES

DRAWN BY: C. Holman	238'-0" X 54'-0" X 16'-0" OSV	
CHK'D. BY: L. Burchfield	PROFILE & ARRANGEMENTS	
APP'D. BY: L. Sanders	SCALE: 1/8" = 1' - 0"	DOB: 12/28/99
PROJECT # 5153	DRAWING # 1.001	HULL: LEEVAC IND 325
		SHEET 1 OF 1